



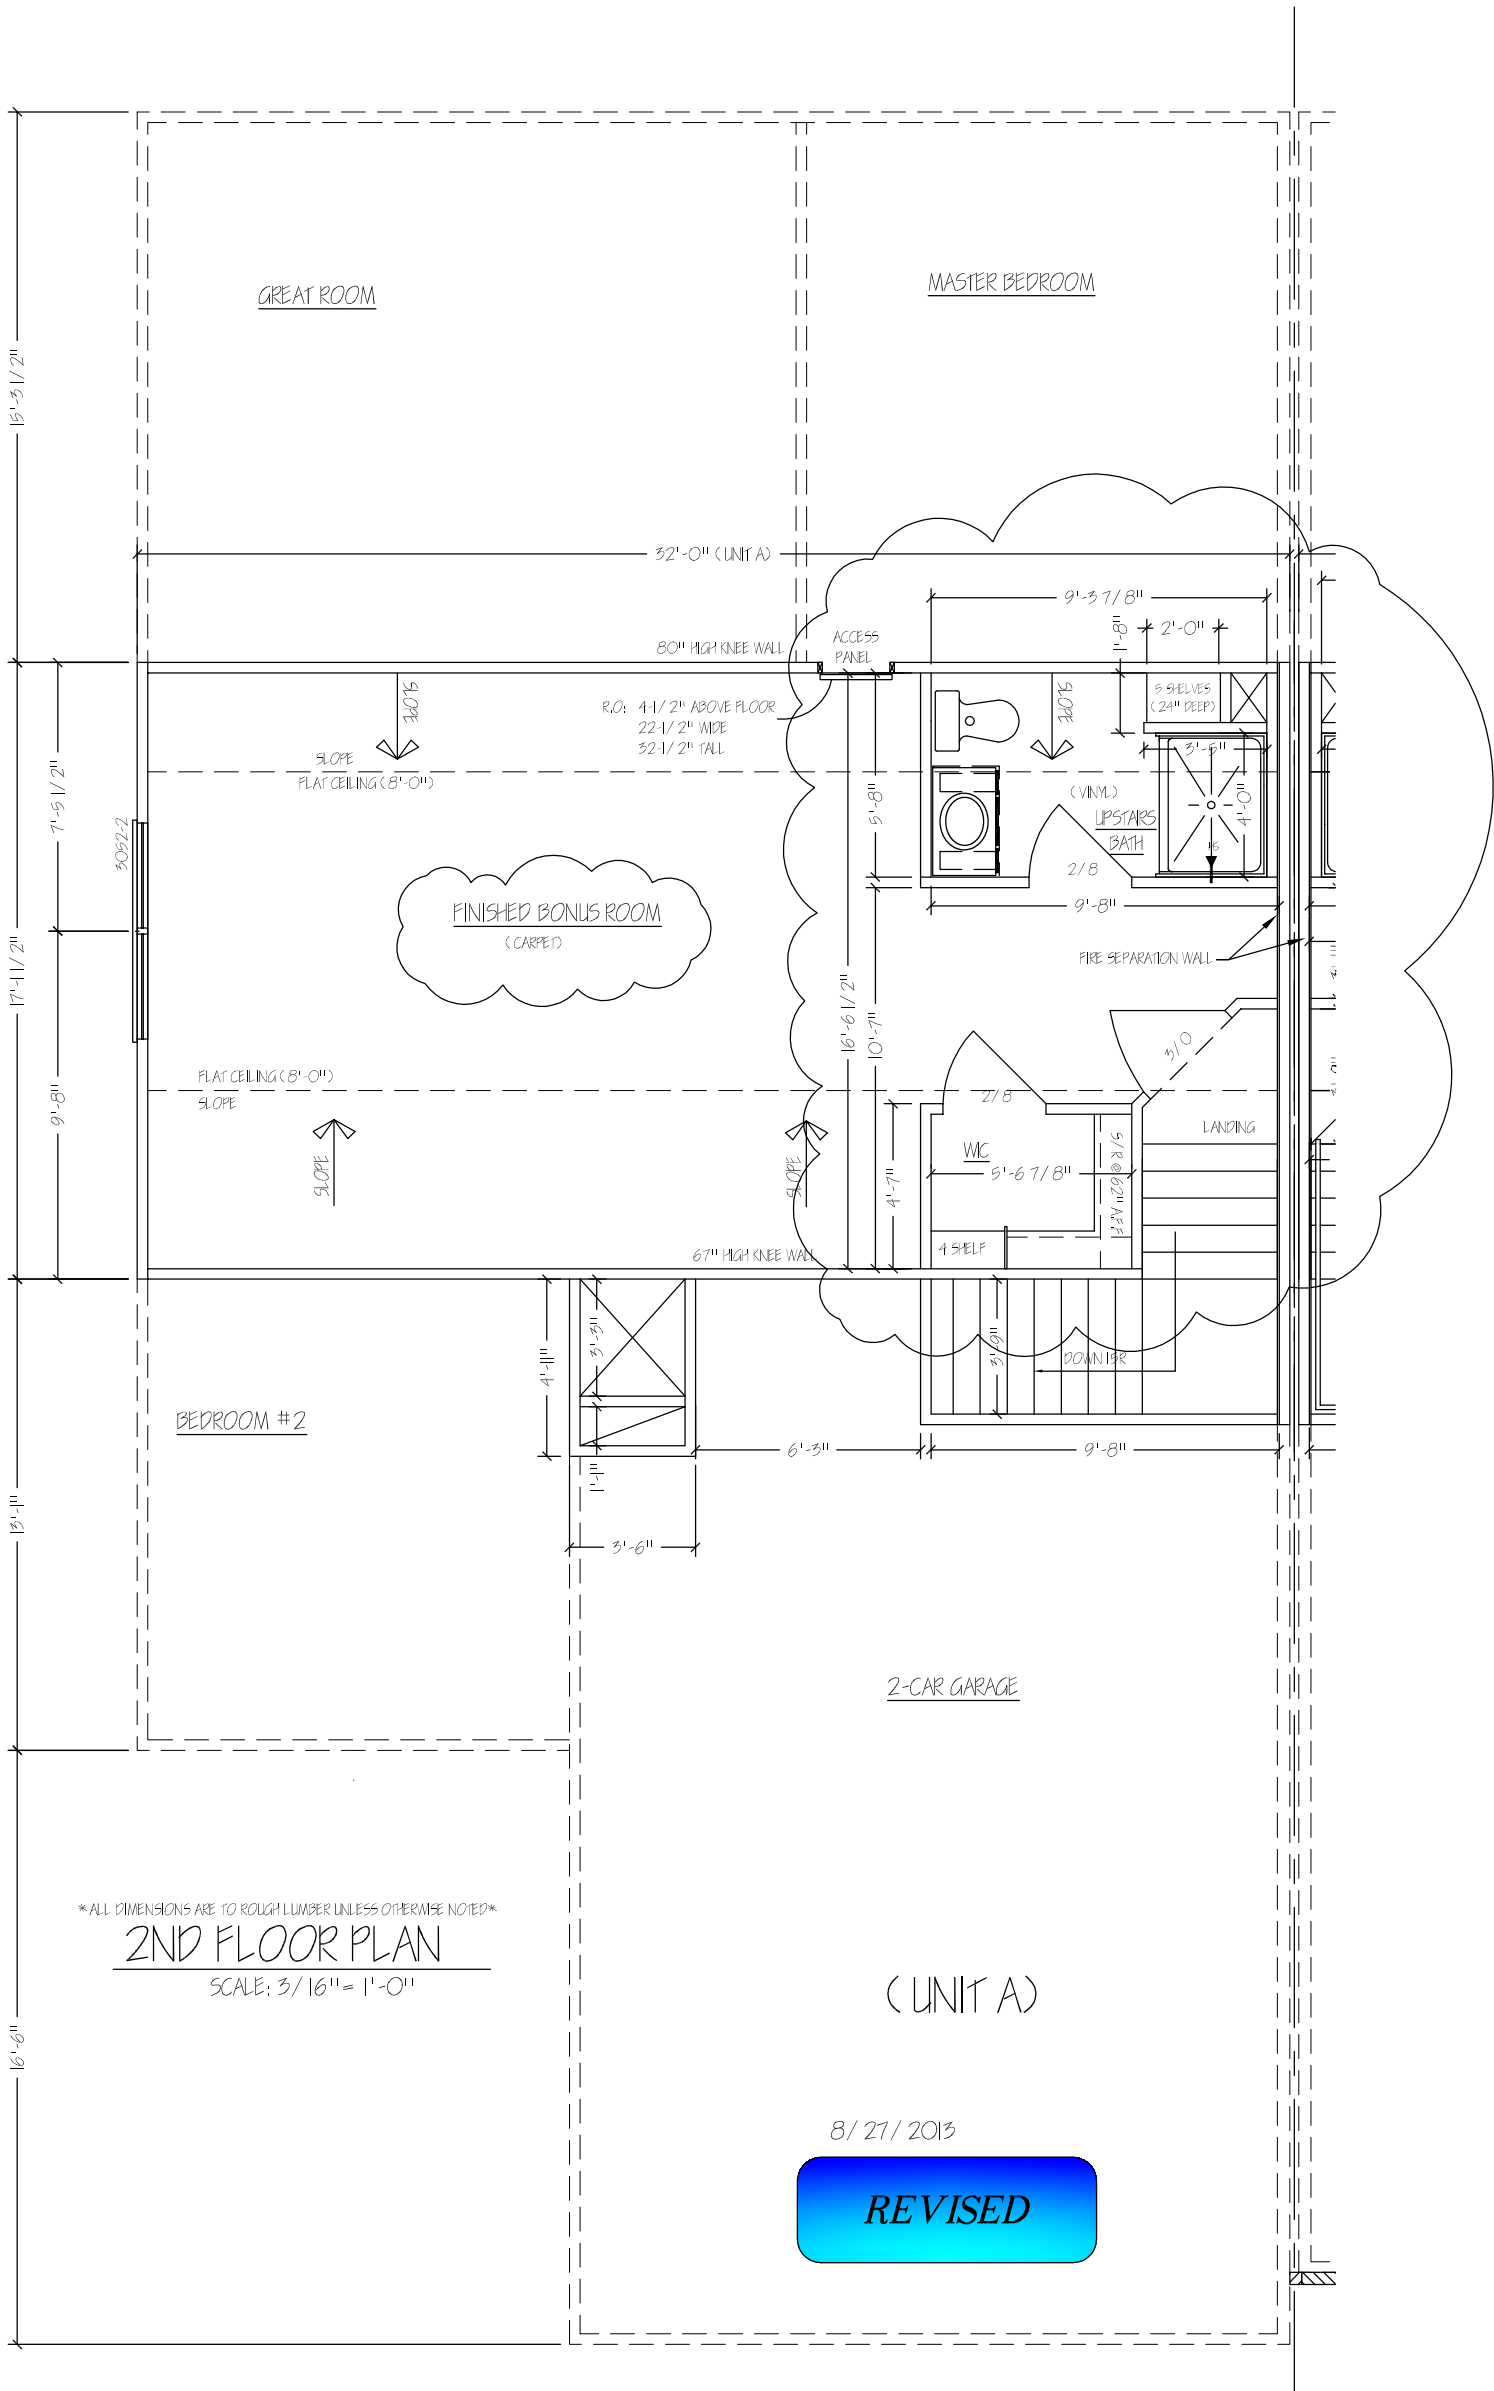

MODEL:	TRADITIONS II (V1008)
BUILT FOR:	SPECULATION HOUSE
SUBDIVISION/LOT:	EAGLEVIEW LOT 248A
ADDRESS:	293 S. PUMPKIN RIDGE COURT COLUMBIA CITY, INDIANA 46725
SHEET DESCRIPTION:	2ND FLOOR SEMI-FINISHED AREA
SHEET NUMBER:	100
SCALE:	SEE PLAN
DATE:	6-29-2012
DESIGNER:	CAF
REVIEWER:	CAF
DATE:	8/27/13

*NOTE: FINISHED SQUARE FOOTAGE CALCULATIONS FOR THIS HOUSE WERE BASED ON PLAN DIMENSIONS ONLY AND MAY VARY FROM THE FINISHED SQUARE FOOTAGE OF THE HOUSE "AS BUILT".

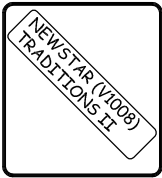

QUOTE FOOTAGE:	
BEST FLOOR:	1295 sqft.
2ND FLOOR FIN. AREA:	1590 sqft.
GARAGE AREA:	529 sqft.
APPROX. TOTAL SF:	2292 sqft.

522 SOUTH 19th STREET, DECATUR, INDIANA 46725
BUILDING TRUST & QUALITY IN EVERY HOME!

ENERGY STAR PARTNER

*** NOTICE ***
THE ORIGINALS AND COPIES OF THESE PLANS, DRAWINGS AND OR RENDERINGS, INCLUDING ANY SPECIFICATIONS ARE COPYRIGHTED. ALL SUCH PLANS DRAWINGS, AND OR RENDERINGS INCLUDING THE SPECIFICATIONS AND THE COPYRIGHT ARE THE PROPERTY OF IDEAL SUBURBAN HOMES INC. IT IS FURTHER ACKNOWLEDGED THAT SUCH PLANS, DRAWINGS RENDERINGS, AND SPECIFICATIONS MAY BE USED FOR THE ABOVE DESCRIBED PROJECT ONLY, AND THAT BLUEPRINTING, XEROXING, TRACING OR OTHER MEANS OF REPRODUCTION OF THE DOCUMENTS BY ANYONE FOR CONSTRUCTION OR ANY OTHER PURPOSES, MAY NOT BE DONE EXCEPT BY IDEAL SUBURBAN HOMES INC. EXPRESS WRITTEN PERMISSION.